

26 1ST FLOOR PLAN
SCALE: 1/4"=1'-0" 0 8 Ft

1ST FLOOR GROSS AREA = 8,633.8 SQ. FT.

- CONSTRUCTION NOTES**
- ① SEMI-RECESSED FIRE EXTINGUISHER CABINET, AND 20# FIRE EXTINGUISHER.
 - ② 3/8" x 3/8" FINAL CORNER GUARD WITH CAPS, RETAINER, AND COVER. IMPROV. MODEL 150 OR EQUAL. COLOR BY ARCHITECT.
 - ③ 2" THICK 4" HIGH PADDED WALL PROTECTION.
- ①
 - ②
 - ③
 - ④
 - ⑤
 - ⑥

FLOOR PLAN LEGEND

	NEW CONSTRUCTION
	DOOR (KEY (SEE SCHEDULE SHEET A1)
	CABINERY (SEE INT. ELEVATIONS)
	PARTITION (KEY (SEE PARTITION TYPES ON SHT A8)
	ROOM NAME AND NUMBER - FINISH SCHEDULE ON SHT A8
	EXTERIOR ELEVATIONS (BUILDING SECTION - SEE A3-A4
	INTERIOR ELEVATION KEY - SEE SHEET A4
	CONSTRUCTION NOTE KEY (SEE THIS SHEET)
	TWO HOUR FIRE RATED PARTITION
	ONE HOUR FIRE RATED PARTITION
	DIMENSION TO FINISHED SURFACE

For Site Plan Review

New Teen Center Never Alone
TREATMENT CENTER
Building 4- Teen Center
20 Crofts Road
Hurley, NY 12443

JOHN LANDRY, RA - ROUTE 9 DESIGN CONSULTING ARCHITECT
104 ELM STREET
NORTHAMPTON, MA 01060

STEVEN T. DRAKULICH ARCHITECTURE
27 JAMES STREET
GREENFIELD, MA 01301
(413) 531-6475


Revisions: 3/14/24

Drawn: ACD, JRH
Checked: STD, JKL

Job #: 2230RKC
Date: 1/14/24

Sheet: 4-A1

FIRST FLOOR PLAN
SCALE: 1/4"=1'-0"
ACTUAL

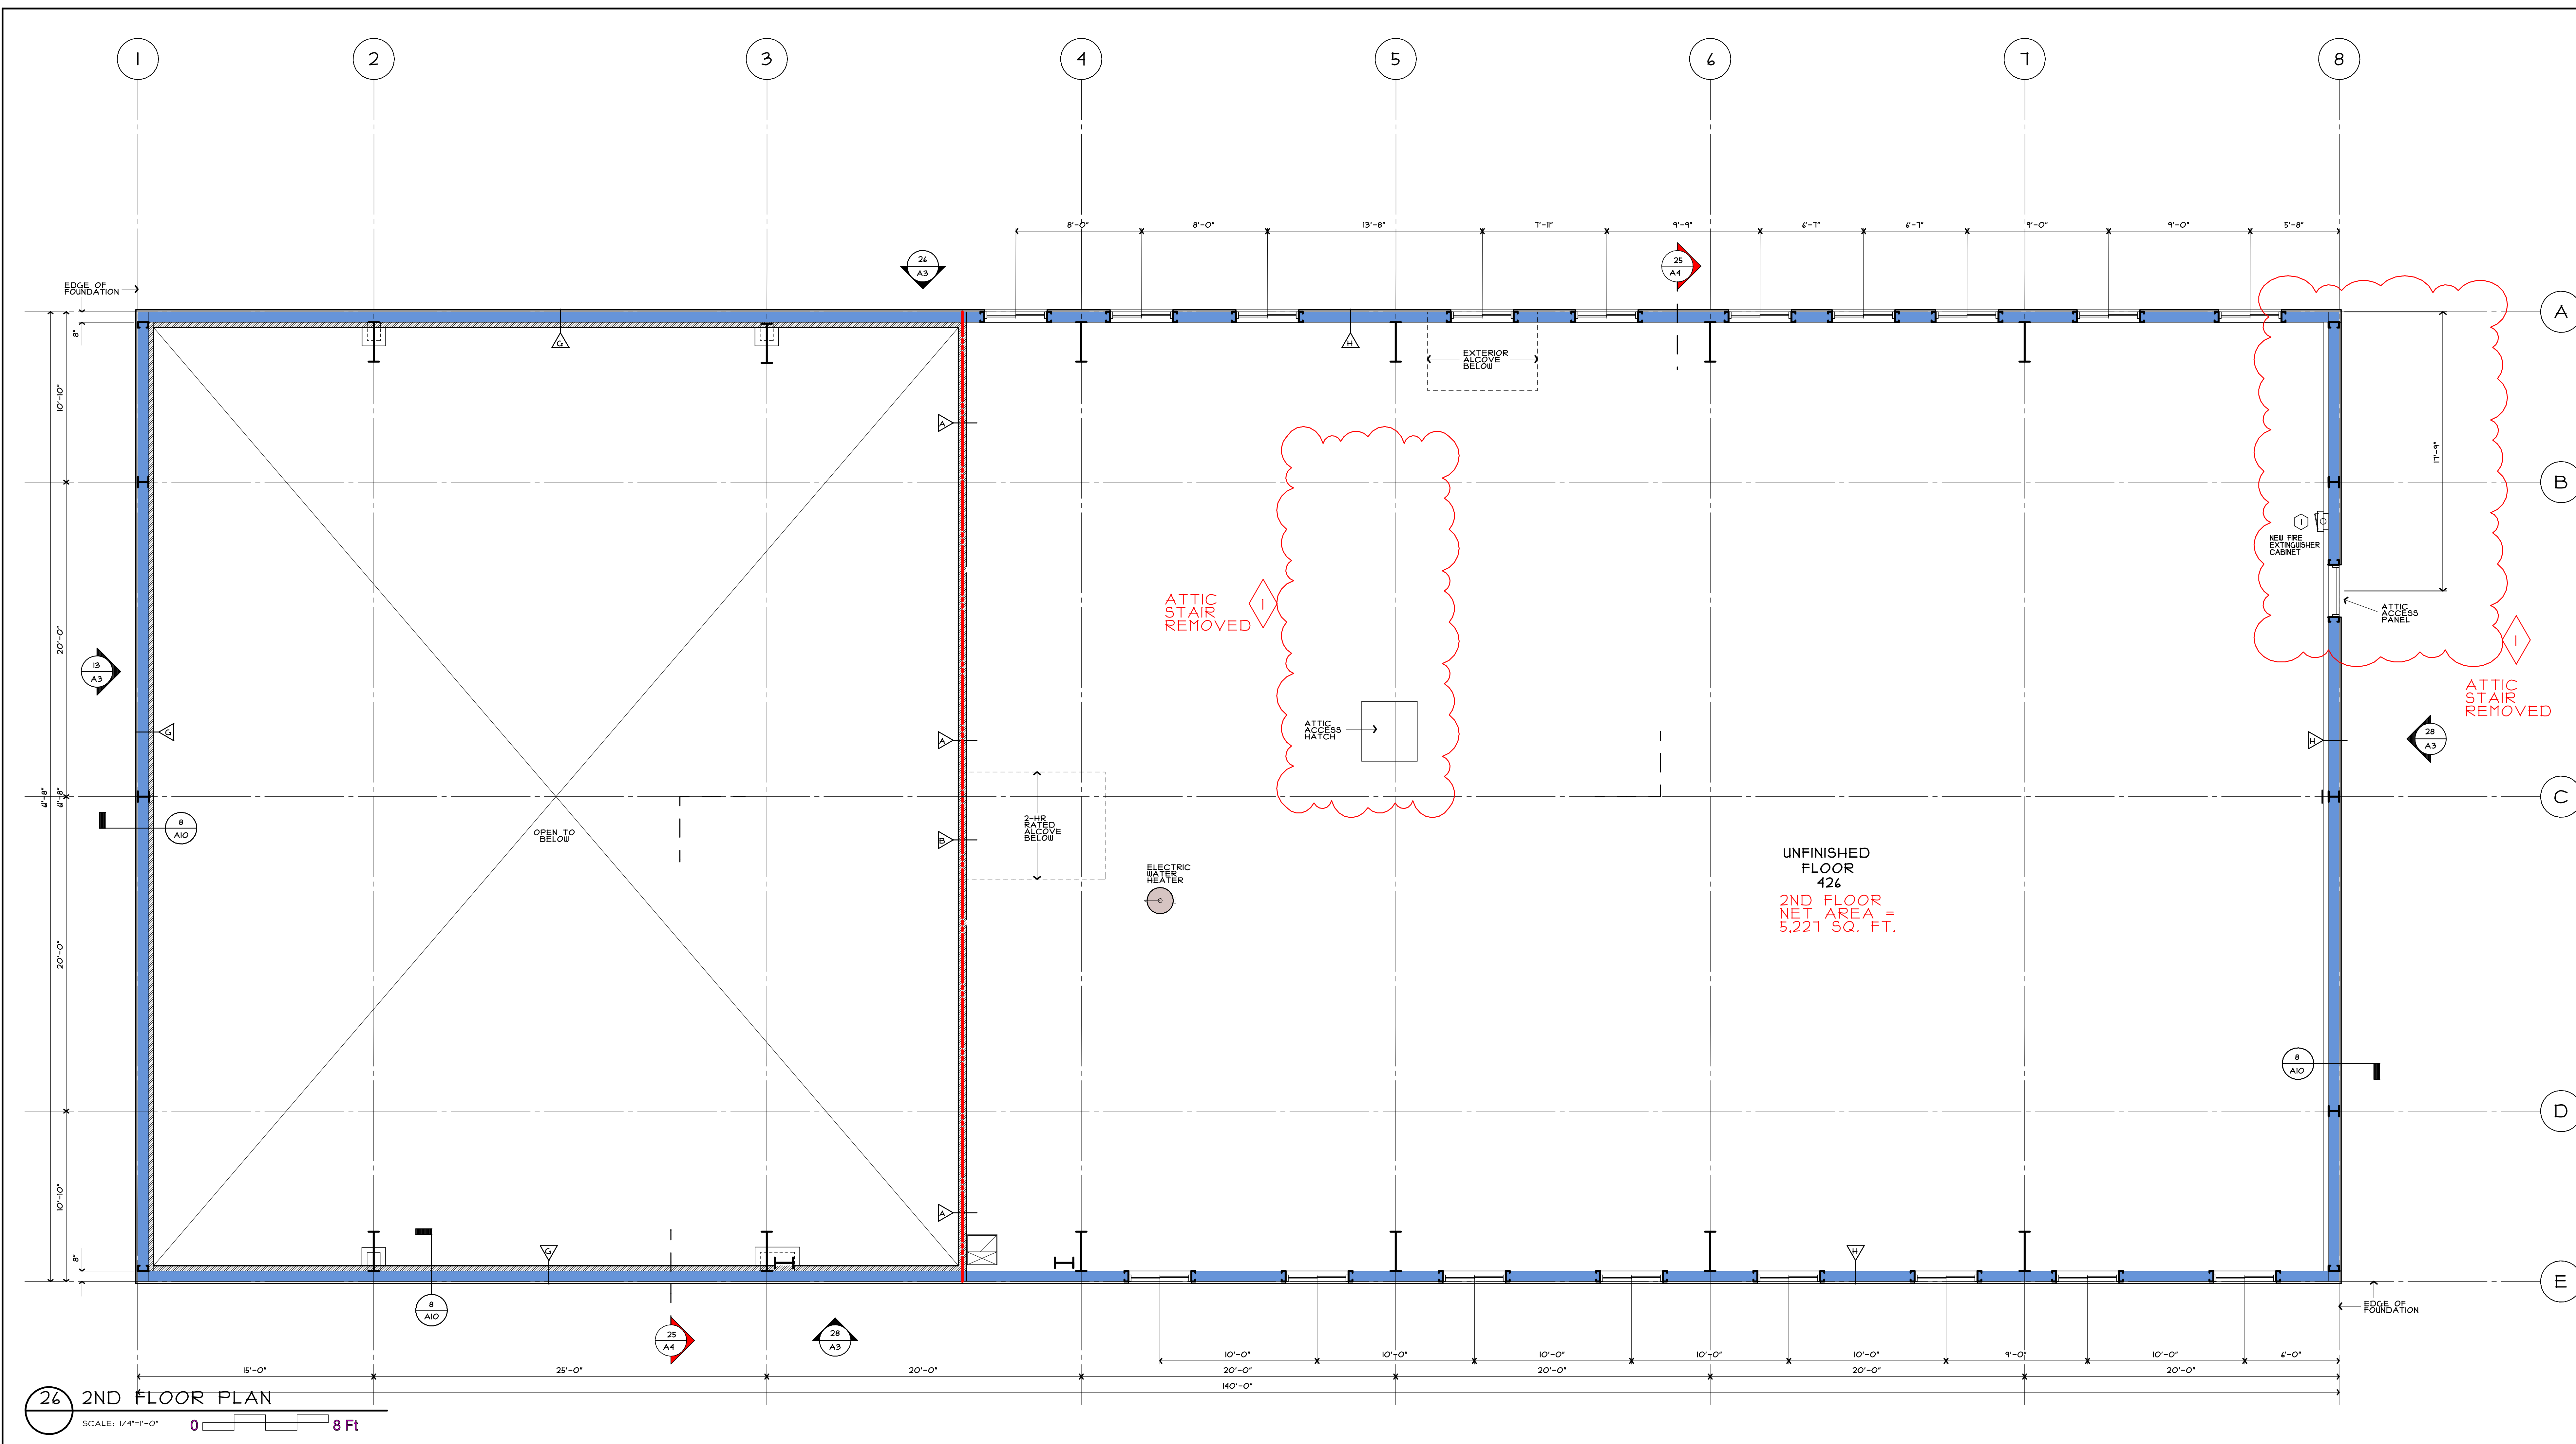

FLOOR PLAN LEGEND	
	NEW CONSTRUCTION
	DOOR & KEY (SEE SCHEDULE SHEET A1)
	CABINETS & SHELVING (SEE INT. ELEVATIONS)
	PARTITION & KEY (SEE PARTITION TYPES ON SHT A8)
	ROOM NAME AND NUMBER - FINISH SCHEDULE ON SHT A8
	EXTERIOR ELEVATIONS & BUILDING SECTION - SEE A3-A4
	INTERIOR ELEVATION KEY - SEE SHEET A6
	CONSTRUCTION NOTE KEY (SEE THIS SHEET)
	TWO HOUR FIRE RATED PARTITION
	ONE HOUR FIRE RATED PARTITION
	DIMENSION TO FINISHED SURFACE

For Site Plan Review

New Teen Center Never Alone
TREATMENT CENTER
Building 4- Teen Center
20 Crofts Road
Hurley, NY 12443

JOHN LANDRY, RA - ROUTE 9 DESIGN CONSULTING ARCHITECT
104 ELM STREET
NORTHAMPTON, MA 01060

STEVEN T. DRAKULICH ARCHITECTURE
27 JAMES STREET
GREENFIELD, MA 01301
(413) 531-6475



Revisions: 3/14/24

Drawn: ACD, JRH
Checked: STD, JKL

Job #: 2230RKC
Date: 1/14/24

Sheet: 4-A2

SCALE: 1/4" = 1'-0" ACTUAL

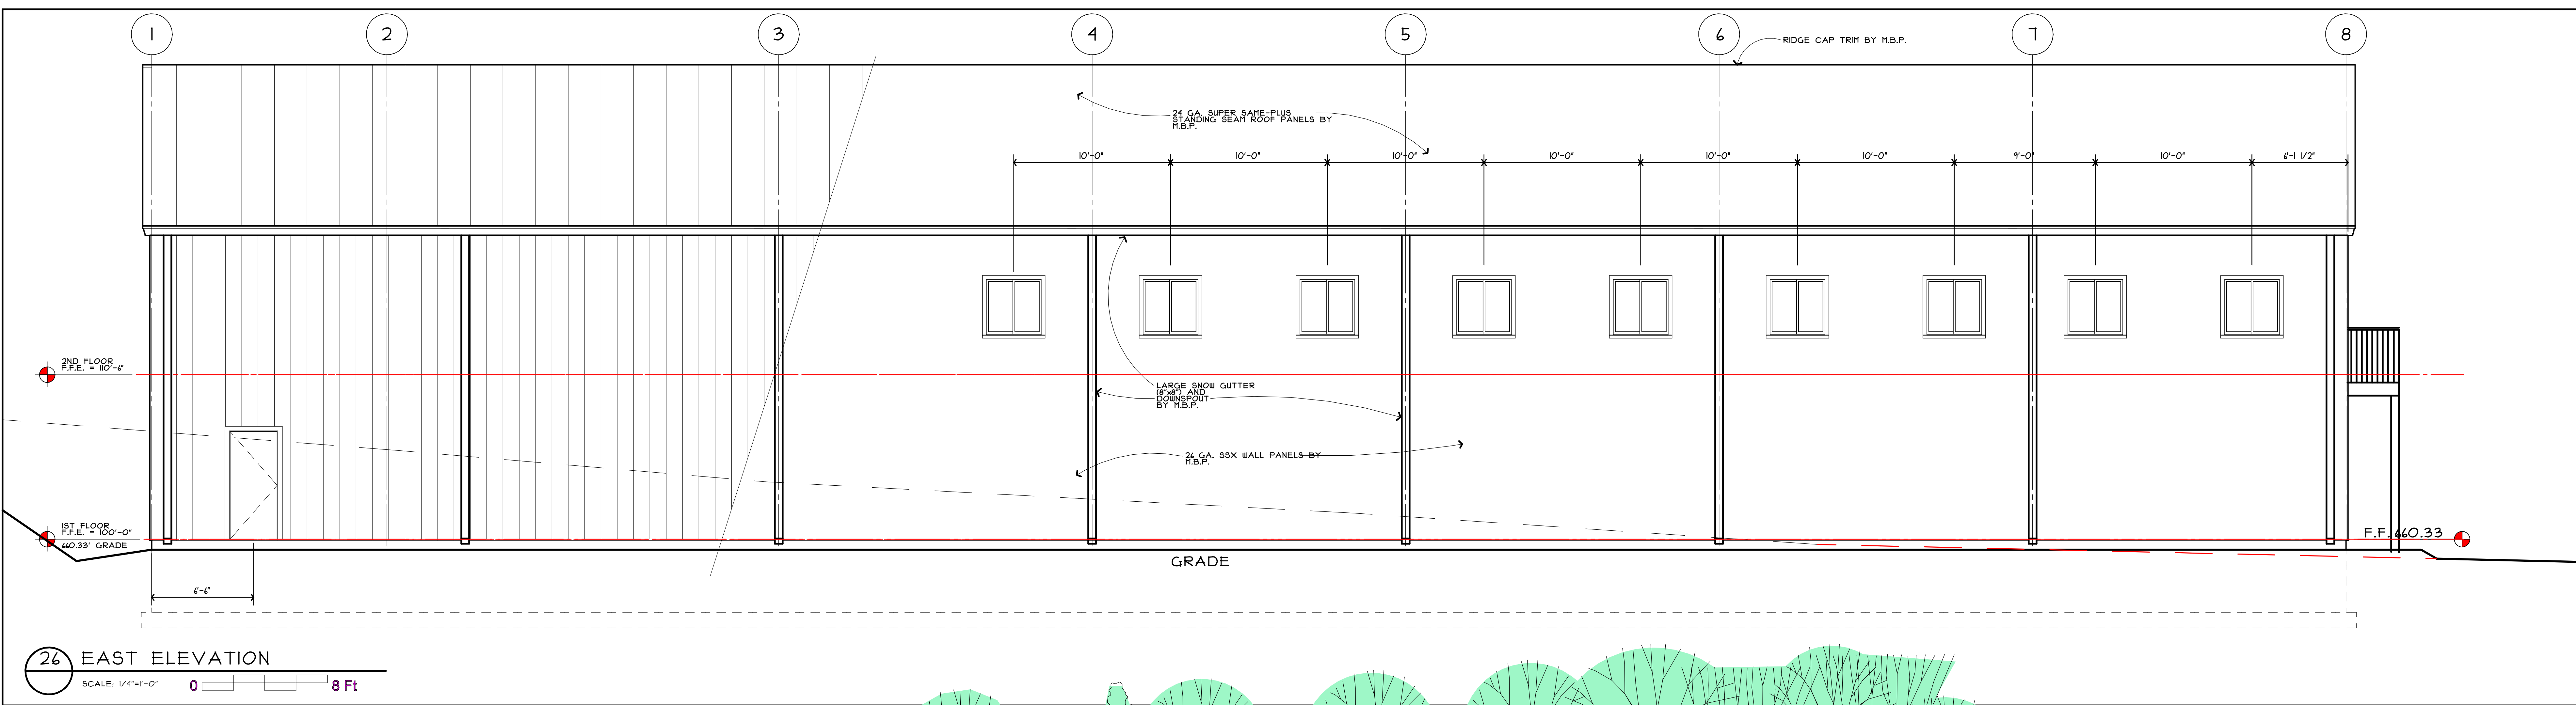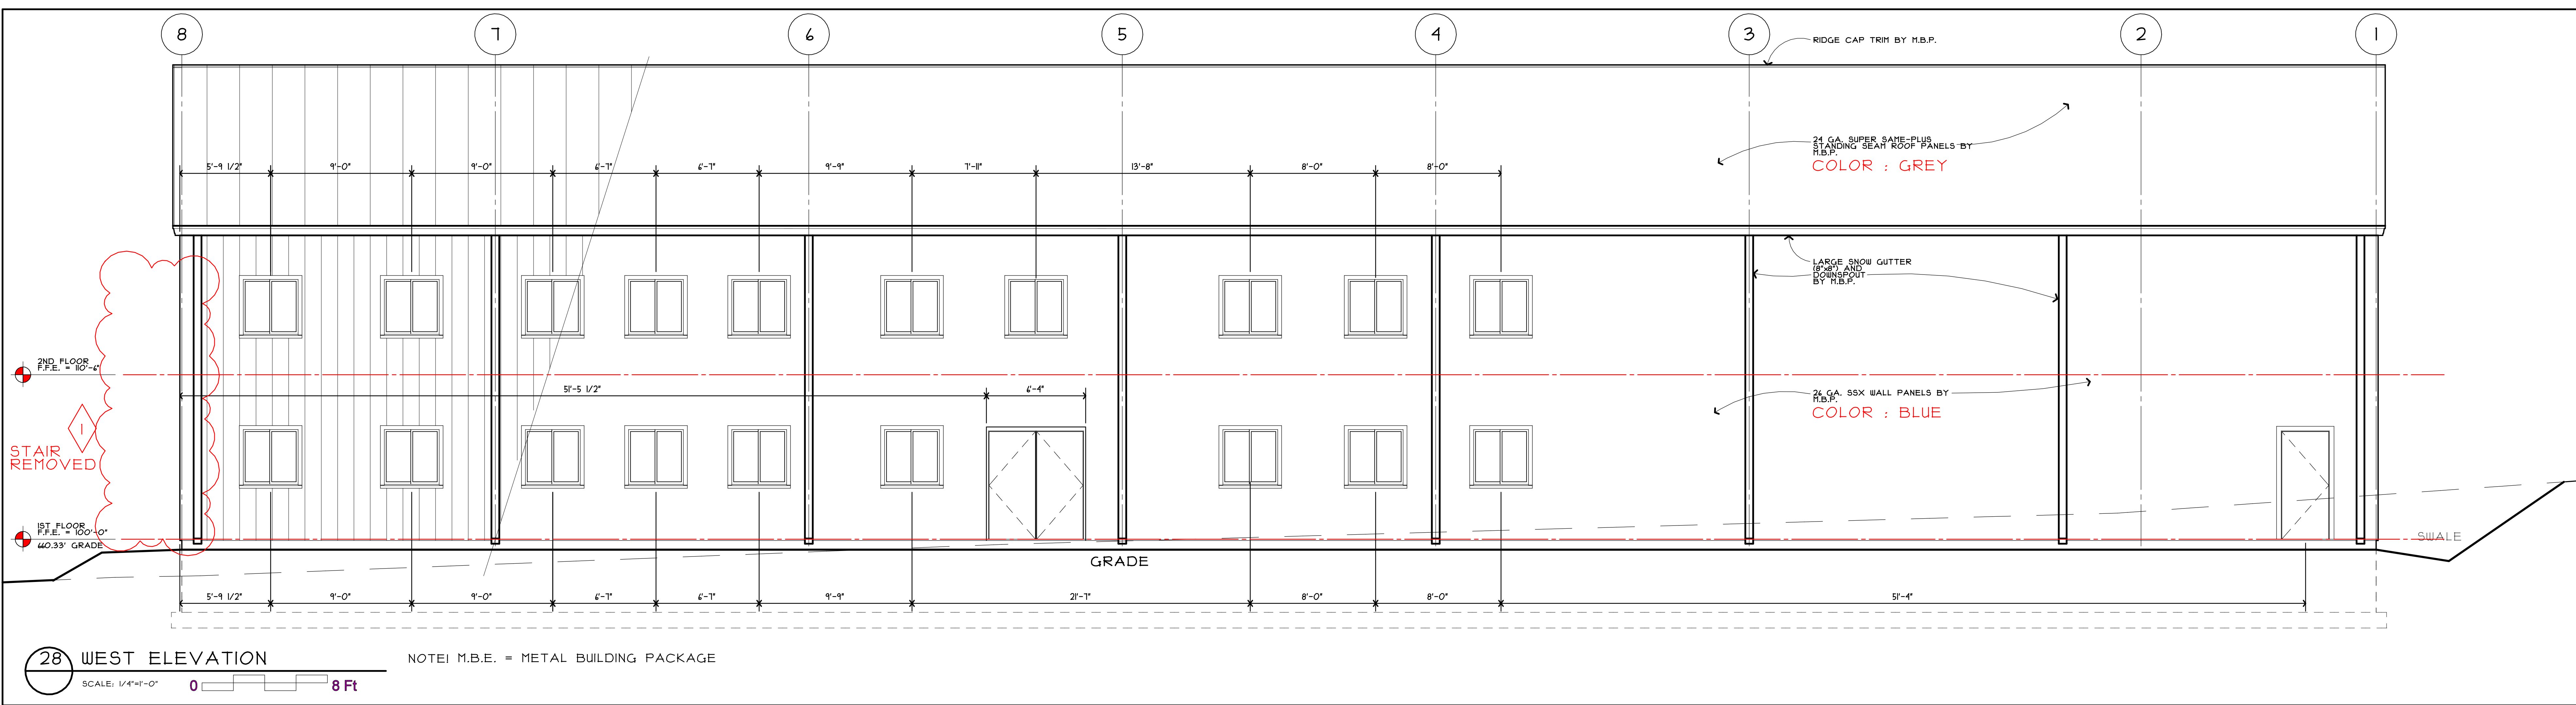

For Site Plan Review

New Teen Center Never Alone
 TREATMENT CENTER
 Building 4- Teen Center
 20 Crofts Road
 Hurley, NY 12443

JOHN LANDRY, RA - ROUTE 9 DESIGN CONSULTING ARCHITECT
 104 ELM STREET
 NORTHAMPTON, MA 01060

STEVEN T. DRAKULICH ARCHITECT
 27 JAMES STREET
 GREENFIELD, MA 01301
 (413) 531-6475


Revisions: 3/4/24

Drawn: JRL, ACD
 Chkd: STD, JKL


Job #: 2230KRC
 Date: 12/23/23

Sheet: **4-A3**


East & West Elevations
 SCALE: 1/4" = 1'-0"

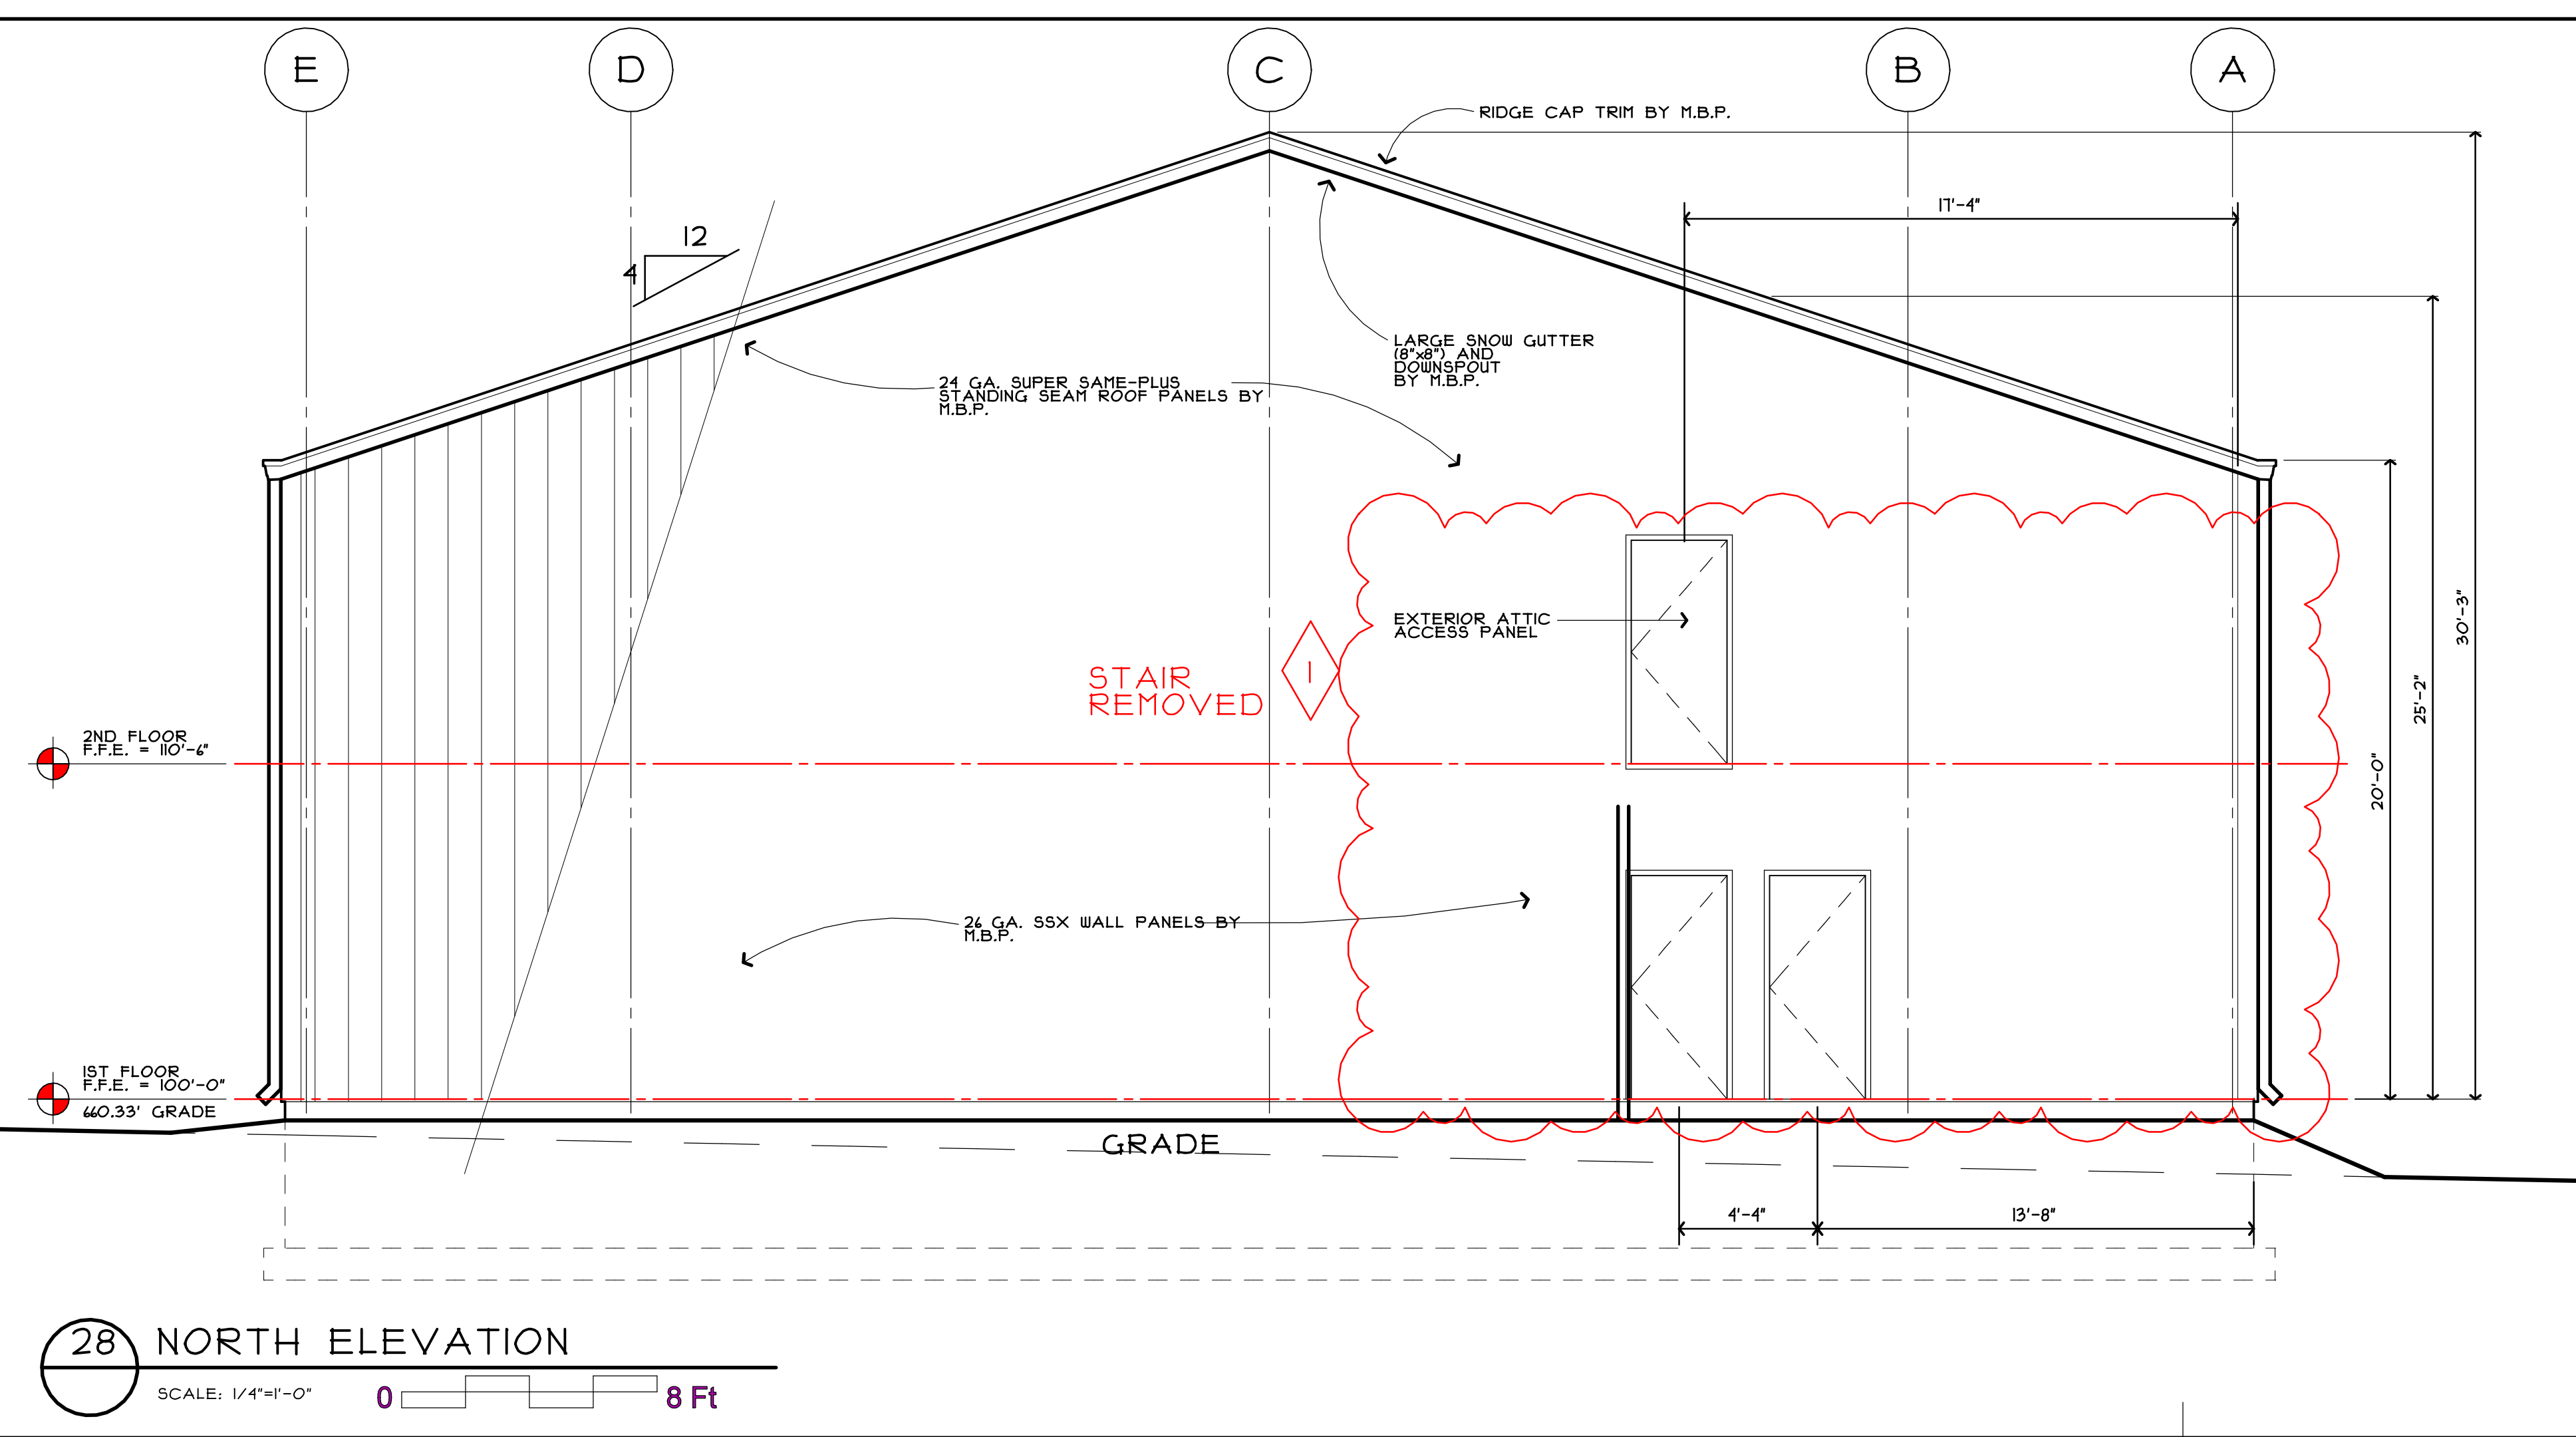

28 NORTH ELEVATION
 SCALE: 1/4"=1'-0" 0 8 Ft

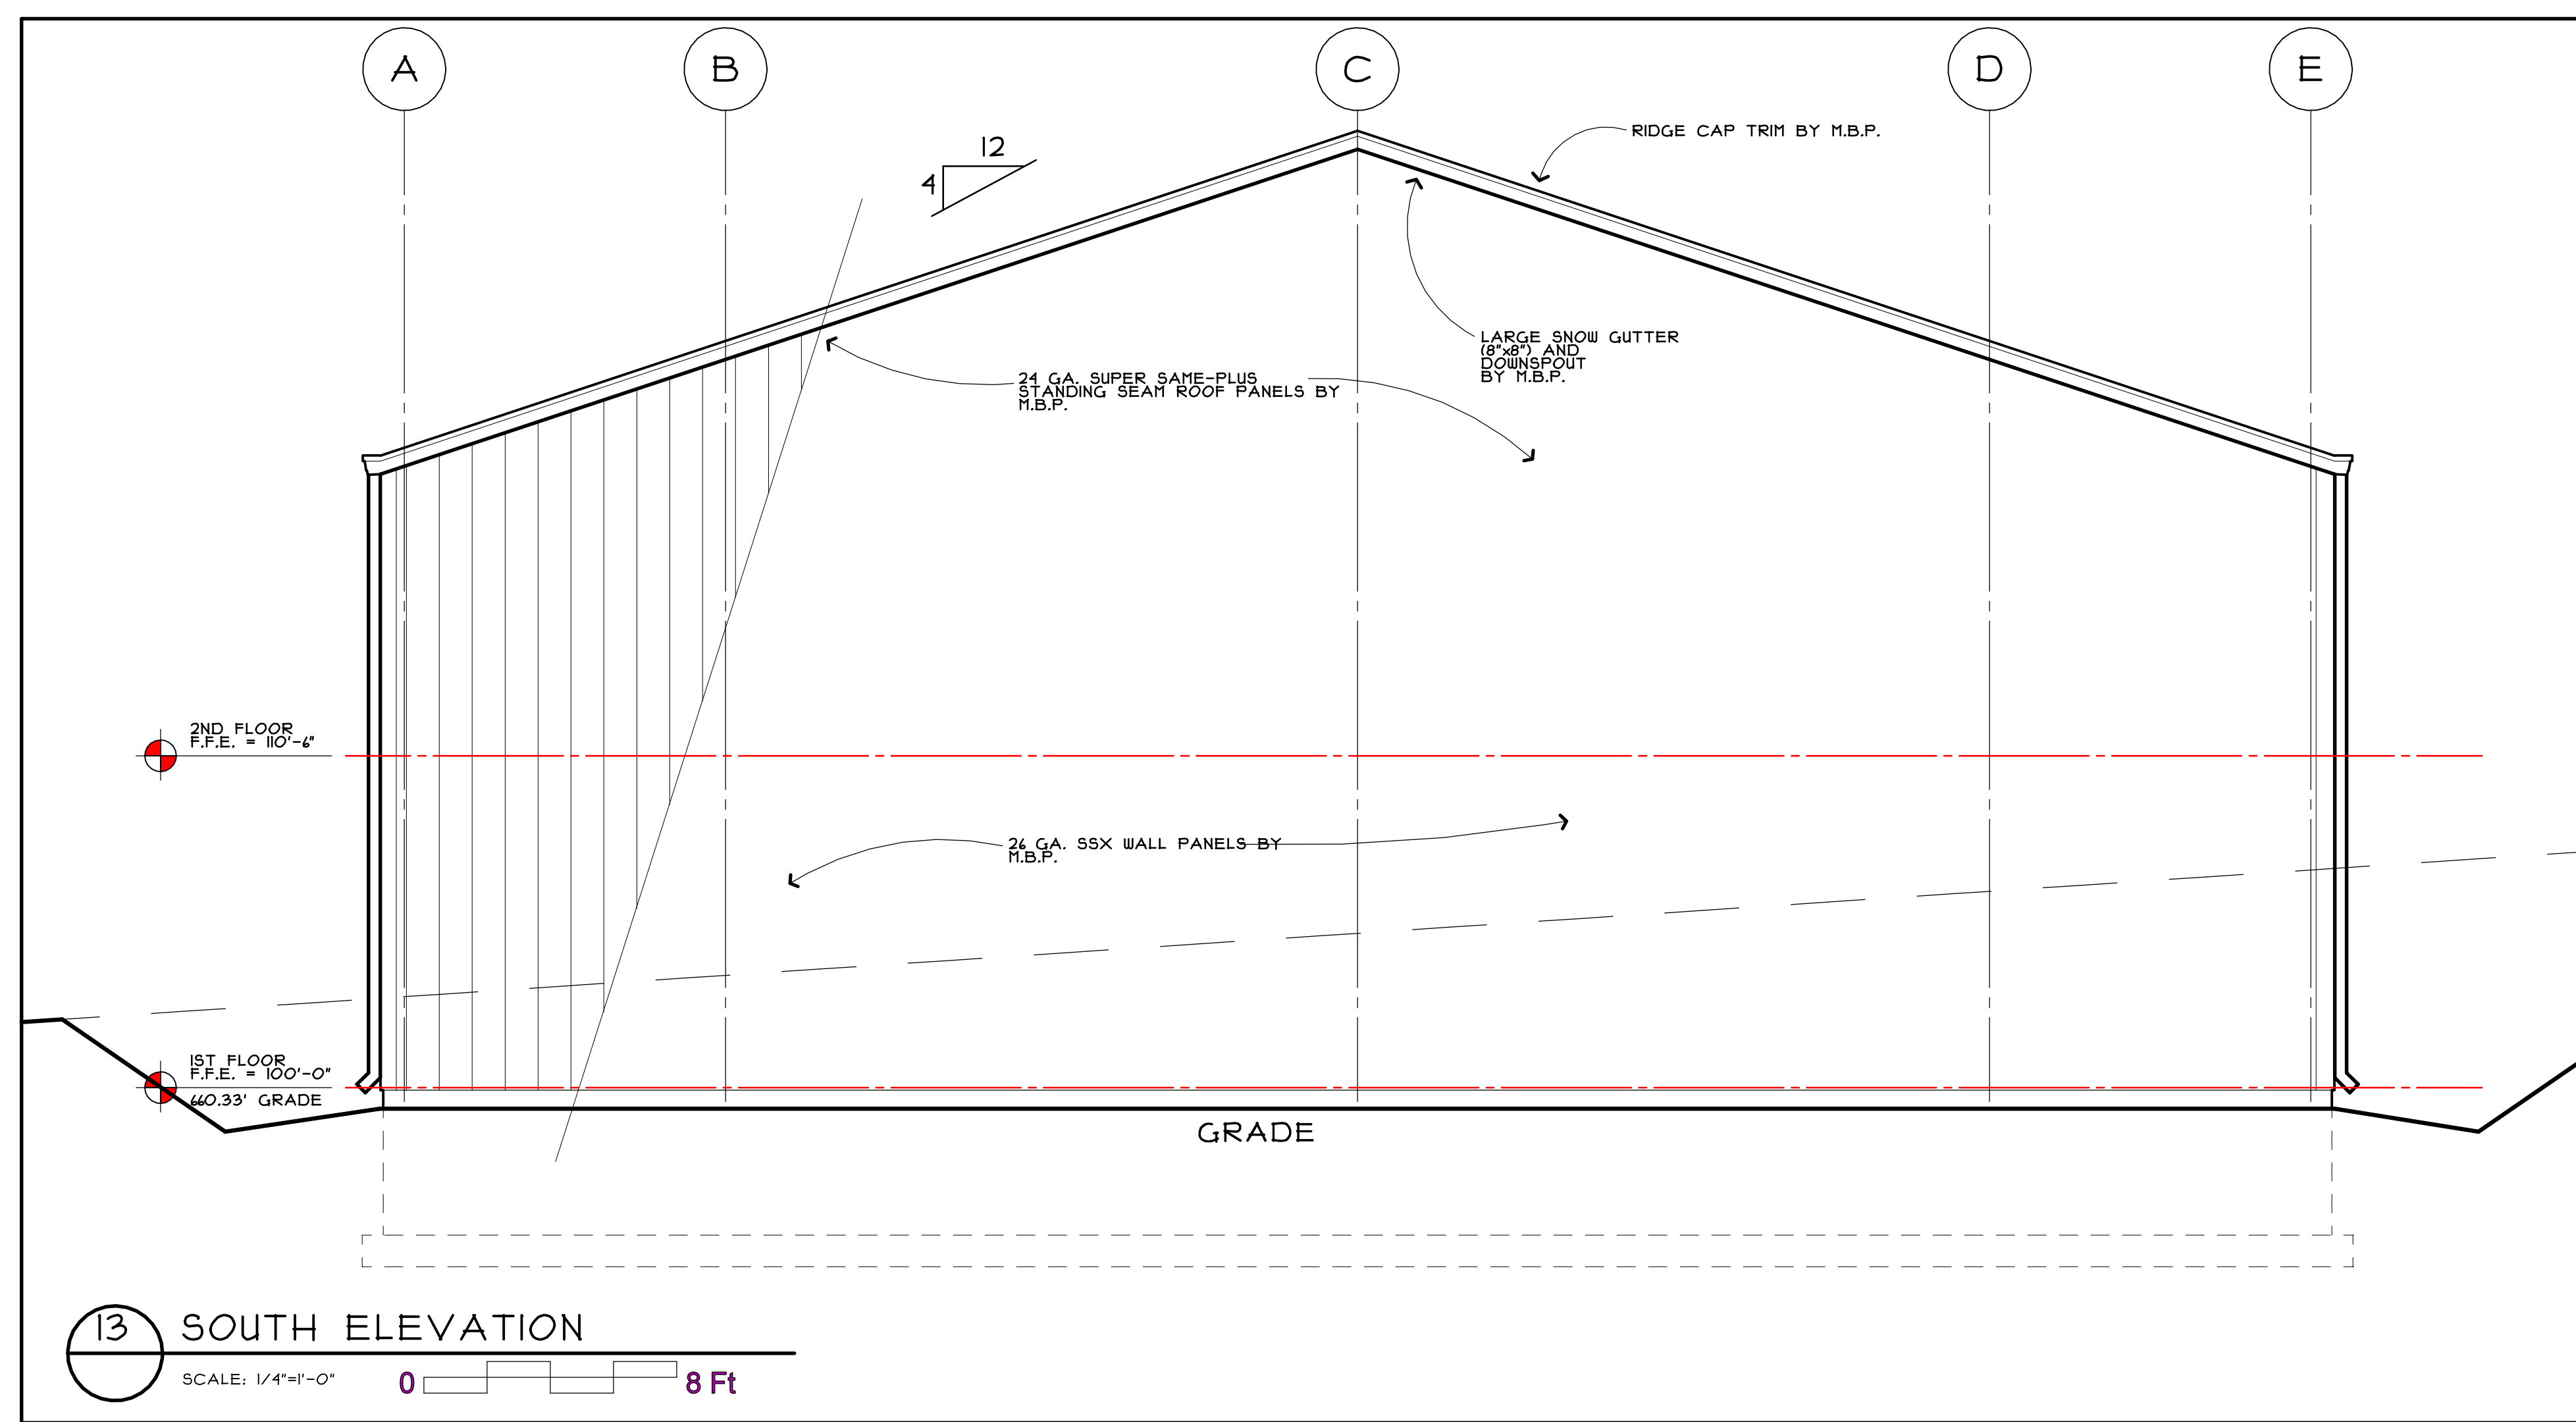

13 SOUTH ELEVATION
 SCALE: 1/4"=1'-0" 0 8 Ft

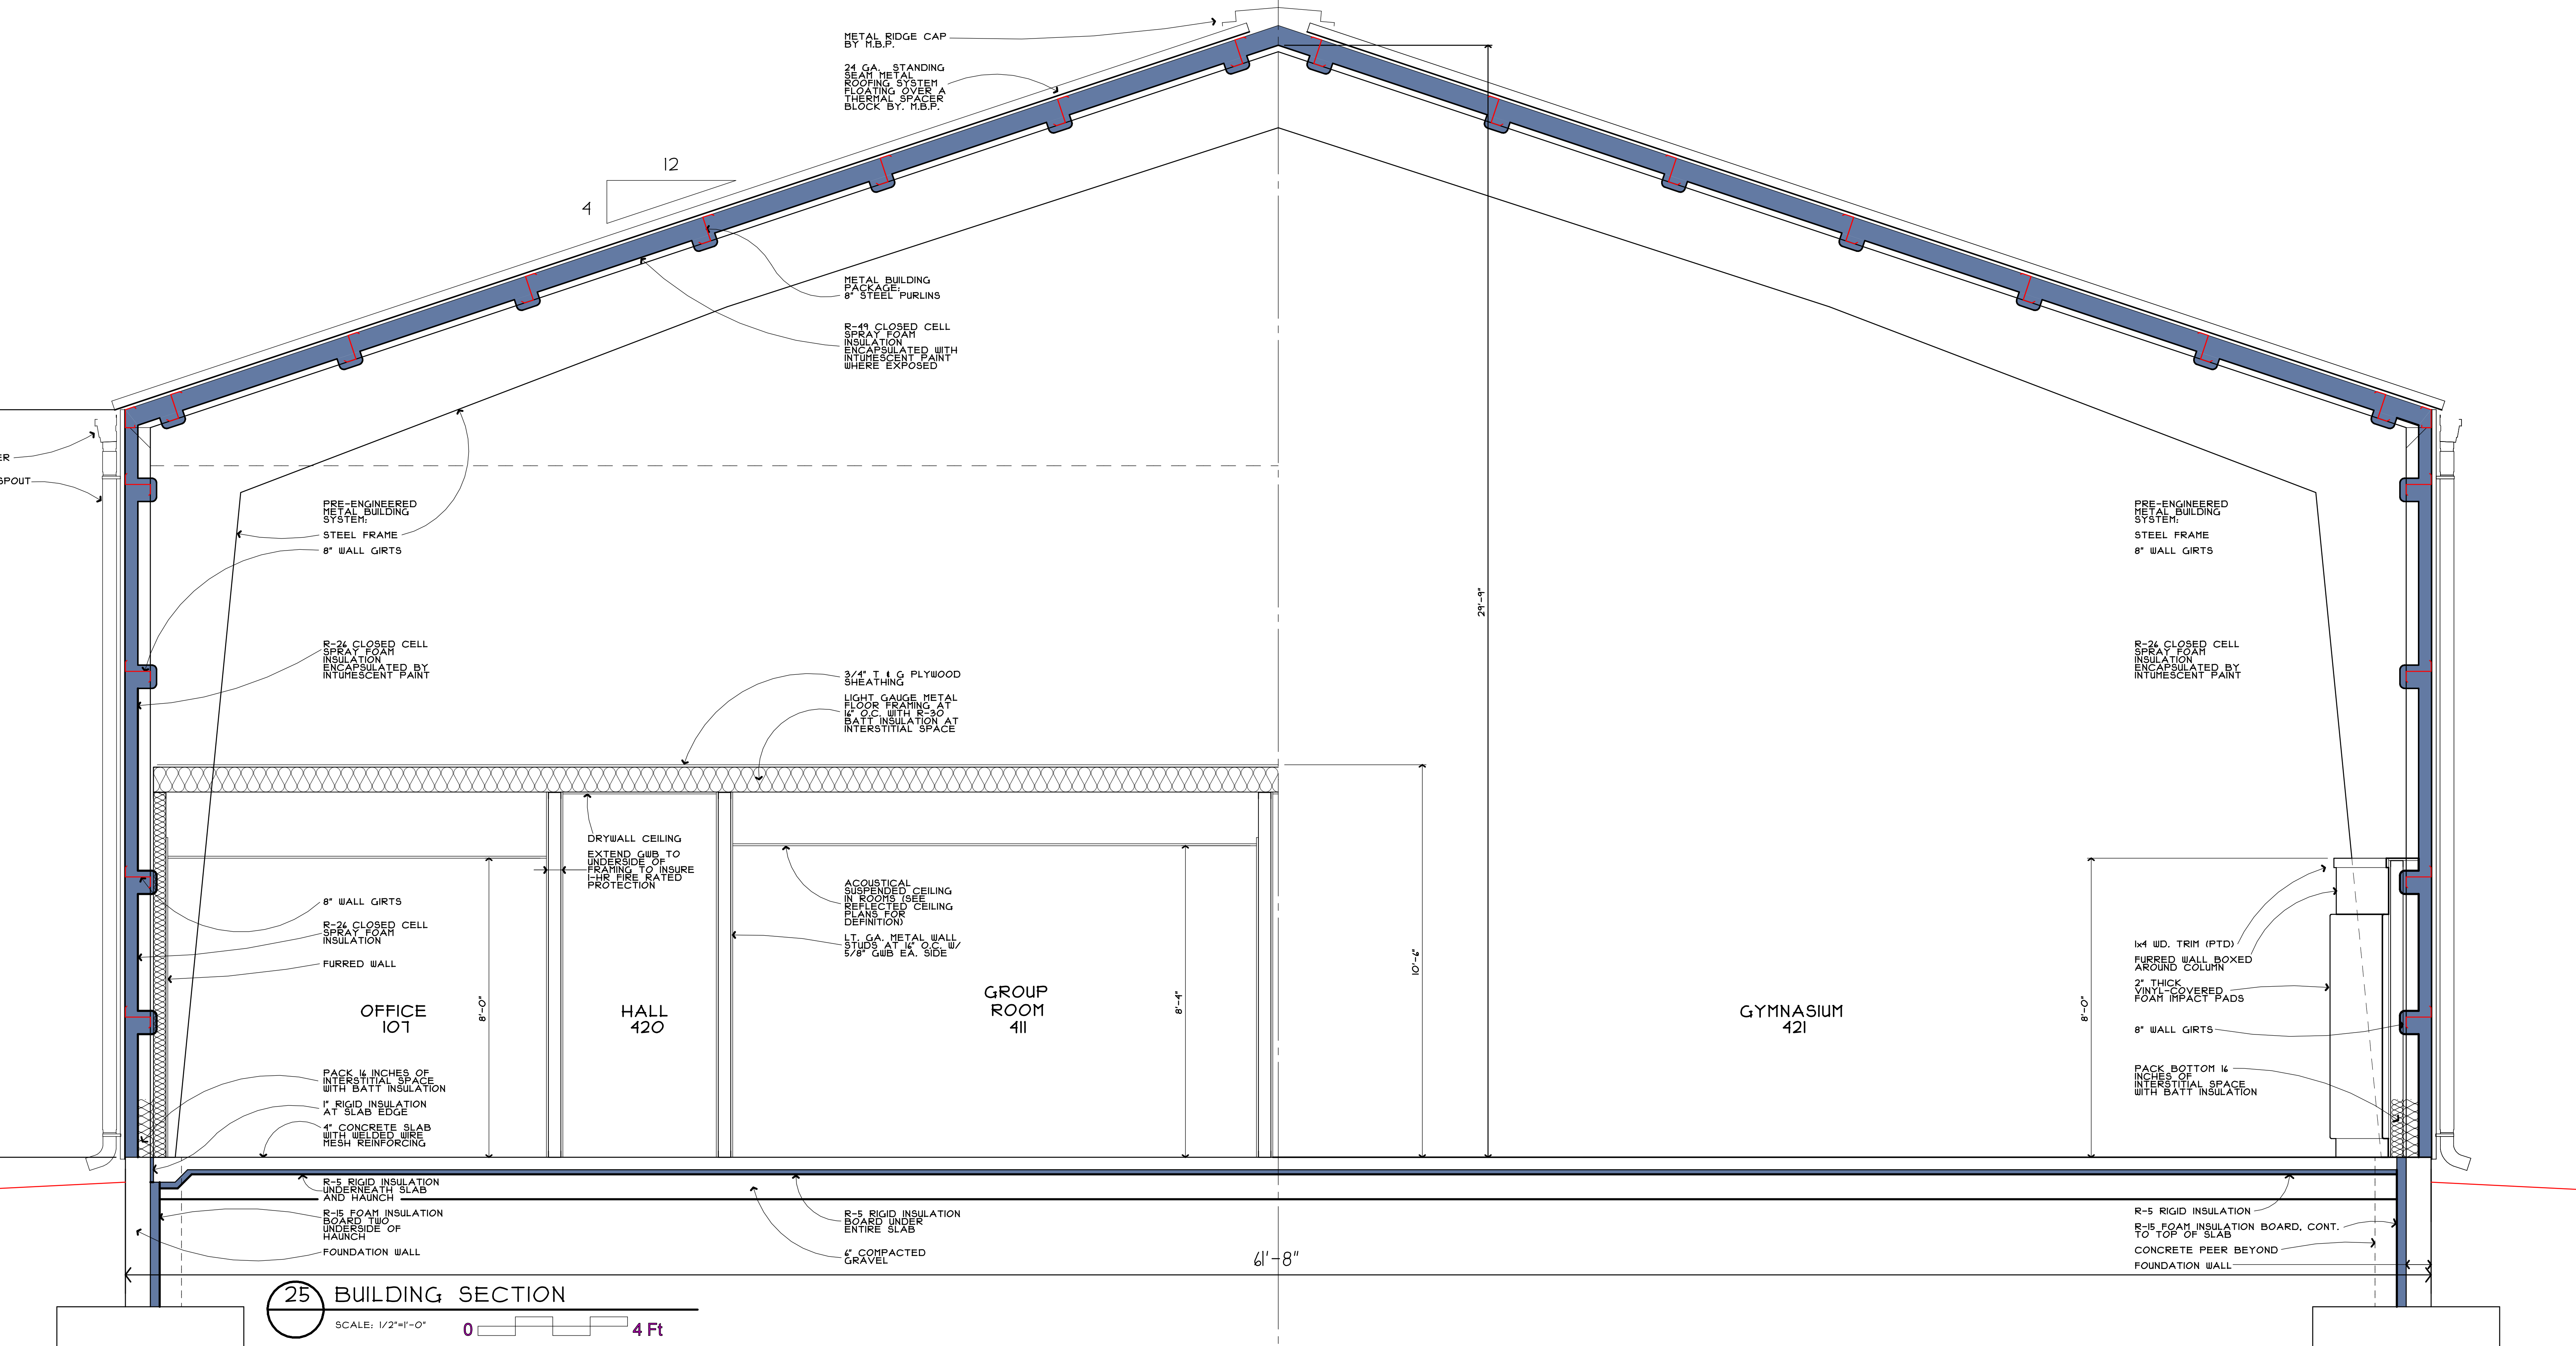

25 BUILDING SECTION
 SCALE: 1/2"=1'-0" 0 4 Ft

For Site Plan Review

**New Teen Center
Never Alone**
 TREATMENT CENTER
 Building 4- Teen Center
 20 Crofts Road
 Hurley, NY 12443

JOHN LANDRY, RA - ROUTE 9 DESIGN CONSULTING ARCHITECT
 104 ELM STREET
 NORTHAMPTON, MA 01060

STEVEN T. DRAKULICH ARCHITECT
 27 JAMES STREET
 GREENFIELD, MA 01301
 (413) 531-6475

Revisions:
 3/4/24

Drawn: JRH, ACD
 Chkd: STD, JKL

Job #: 2230RKC
 Date: 12/23/23

Sheet: **4-A4**

North South Elevations & Section
 SCALE: AS SHOWN